


JACKSON COUNTY DEPARTMENT OF PUBLIC HEALTH

REFERENCE NUMBER J58171L IMPROVEMENT PERMIT	DATE 03.02.06	PIN 7568-93-3297	
APPLICANT: CAULEY PHILIP MATTHEW PO BOX 386 CULLOWHEE NC 28723		OWNER: CAULEY, PHILIP MATTHEW & CAULEY, SUSANN PO BOX 386 CULLOWHEE NC 28723	
TELEPHONE: 293-3708			
SPECIFICATIONS: 3			
LOCATION/DIRECTIONS: HWY 107S PAST CANEY FORK L ONTO STAGHORN LN BEFORE TUCKASEEGEE			
FEE: 180	7648	RECEIPT:	SIGNATURE OF OWNER OR AUTHORIZED AGENT: <i>Farell Copy 3-31-06 [Signature]</i>

The above signature indicates that I have read, understood and concur with all provisions and information as outlined on the back.

SLOPE 2% TEXTURE P STRUCTURE P DEPTH 48"
 IN. DRAIN P EX. DRAIN P LTAR -5 OVERALL P

REMARKS: *Area indicated ok for 3 Bedroom Septical Repair using Paved Block type drainfield. A pump and pump tank may be required depending on house elevation.*

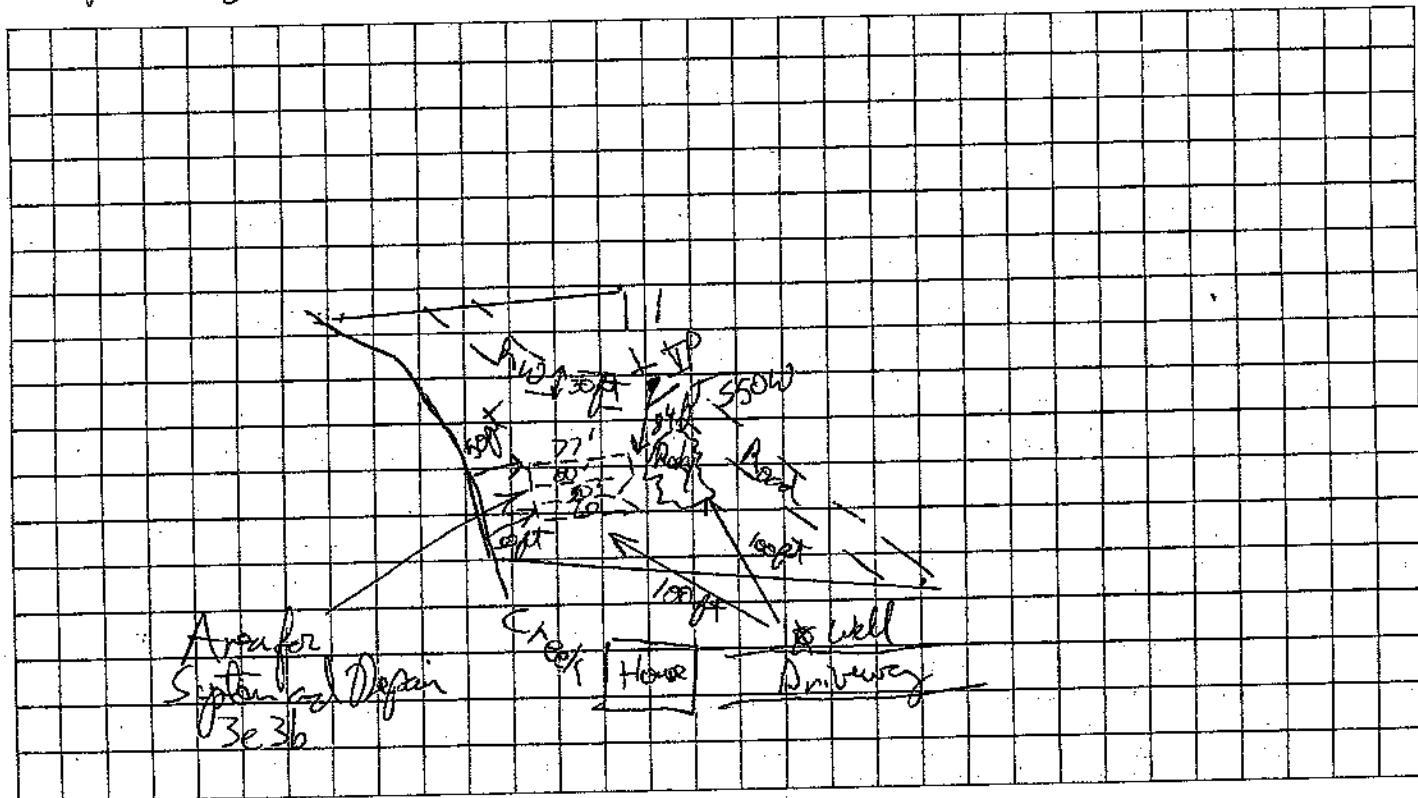

OWNER/INSTALLER RESPONSIBLE FOR COMPLIANCE WITH ALL APPLICABLE STATE RULES

DATE 3-31-06

ENV HEALTH SPEC *[Signature]*