

## APPLICATION FOR ENVIRONMENTAL SERVICES

## DIVISION OF GROUNDWATER PROTECTION

SEPTIC SYSTEM PERMITLandowner: (Robert Douglas Loney)Name Doug LoneyAddress P. O. Box 31

Lewisburg, TN 37091-0031

Daytime

Phone 359-2876Applicant: (Robert Douglas Loney)Name Doug LoneyAddress P. O. Box 31

Lewisburg, TN 37091-0031

Daytime

Phone 359-2876Is the lot in a subdivision? no Name of Subdivision \_\_\_\_\_

Lot # \_\_\_\_\_

Give specific directions: West on Hwy 272.Turn left at Possum Trot grocery. Lipping 2 miles  
to 2<sup>nd</sup> house on right.Type of Structure: House  Mobile Home \_\_\_\_\_ Other (explain) \_\_\_\_\_Type of water supply: Public \_\_\_\_\_ Well \_\_\_\_\_ Spring Size of lot/tract: 8 Number of bedrooms 3 No. of occupants 1

Will structure have a basement/cut? \_\_\_\_\_ If yes, will basement have plumbing \_\_\_\_\_

If so, what type of plumbing: bathroom \_\_\_\_\_ washing machine \_\_\_\_\_

Other (explain) \_\_\_\_\_

Is the lot staked? (corners) \_\_\_\_\_ If the lot is less than 5 acres in size, lot staking is needed.

Are the 4 corners of the house staked? \_\_\_\_\_ If not, when will it be staked? \_\_\_\_\_

STRUCTURE LOCATION MUST BE STAKED PRIOR TO PERMIT VISIT BEING MADE.Name of Installer, if known ?

Use the back of this sheet to sketch site showing house location, driveway, roads and any other important features at site.

I certify that the above information is true and correct to the best of my knowledge.

Signature Doug Loney Date 4/13/92 Receipt No. 2779

MAKE CHECK PAYABLE TO: TREASURER, STATE OF TENNESSEE.

ALL FEES ARE DUE IN ADVANCE AND ARE NON-REFUNDABLE.

Permit fee is \$100.00 per permit up to 1,000 gallons per day; \$50.00 for each additional 1,000 gallons per day.

**TENNESSEE DEPARTMENT OF HEALTH AND ENVIRONMENT**  
**PERMIT FOR CONSTRUCTION OF SUBSURFACE SEWAGE DISPOSAL SYSTEM**

Issued to Doug Lowery  
 Owner, Developer, Contractor, Installer, Etc.  
 Location: 2149 Tally Rd.  
BEFAST

Installation:  
 1. New Installation  
 2. Repair to Existing System  
 Establishment:  
 1. Residential: # Bedrooms 2  
 2. Other: \_\_\_\_\_  
 (specify)  
 Gal/Day \_\_\_\_\_

Evaluation Based Upon:  
 1. Soil typing by Soil Scientist  
 2. Soil Percolation Test  
 3. Environmental Specialist  
 Estimated Absorption Rate:  
45'  
 Minutes per inch  
 Conventional Systems:  
 Type of System:  1. Standard  
 2. Alternating  
 3. Chapter 68-13-403  
 4. Other \_\_\_\_\_

Permit Requirements Based Upon:  
 Soil Texture/Structure  
 Soil Depth  
 Soil Drainage  
 Presence of Restrictive Layers  
 Position

Alternative Systems:  
 1. Low Pressure Pipe  
 2. Mound  
 3. Lagoon  
 4. Large diameter graveless pipe  
 5. Other \_\_\_\_\_

See attached design package

This system shall consist of a two compartment septic tank holding 1000 gallons, with 200 linear feet in 2-3 trenches, 36 inches wide and 24 inches deep.

Also required:

1. Curtain Drain  
 2. Flow Diversion Valve  
 3. Sewage Pump  
 4. Other: \_\_\_\_\_


All installers of subsurface sewage disposal systems must hold a valid annual license from the Tennessee Department of Health and Environment.

The recipient of this permit agrees to construct or have constructed the above described system in accordance with 68-13-401 et seq. and The Regulations To Govern Subsurface Sewage Disposal Systems. If any part of the system is covered before being inspected and approved, it shall be uncovered by the recipient of the permit at the direction of personnel of the Department of Health and Environment. Any cutting, filling or alterations of the soil conditions on the aforementioned property after this day may render this approval null and void.

X Doug Lowery \_\_\_\_\_ Date 4-15-92  
 (Signature of Recipient)

Issued at Lewisburg Tennessee, in Marshall County  
 By Don Odum Env. Spec. Date 4-15-92  
 (Name and Title) (Date of Issue)

This permit is valid for 3 years from date of issue.

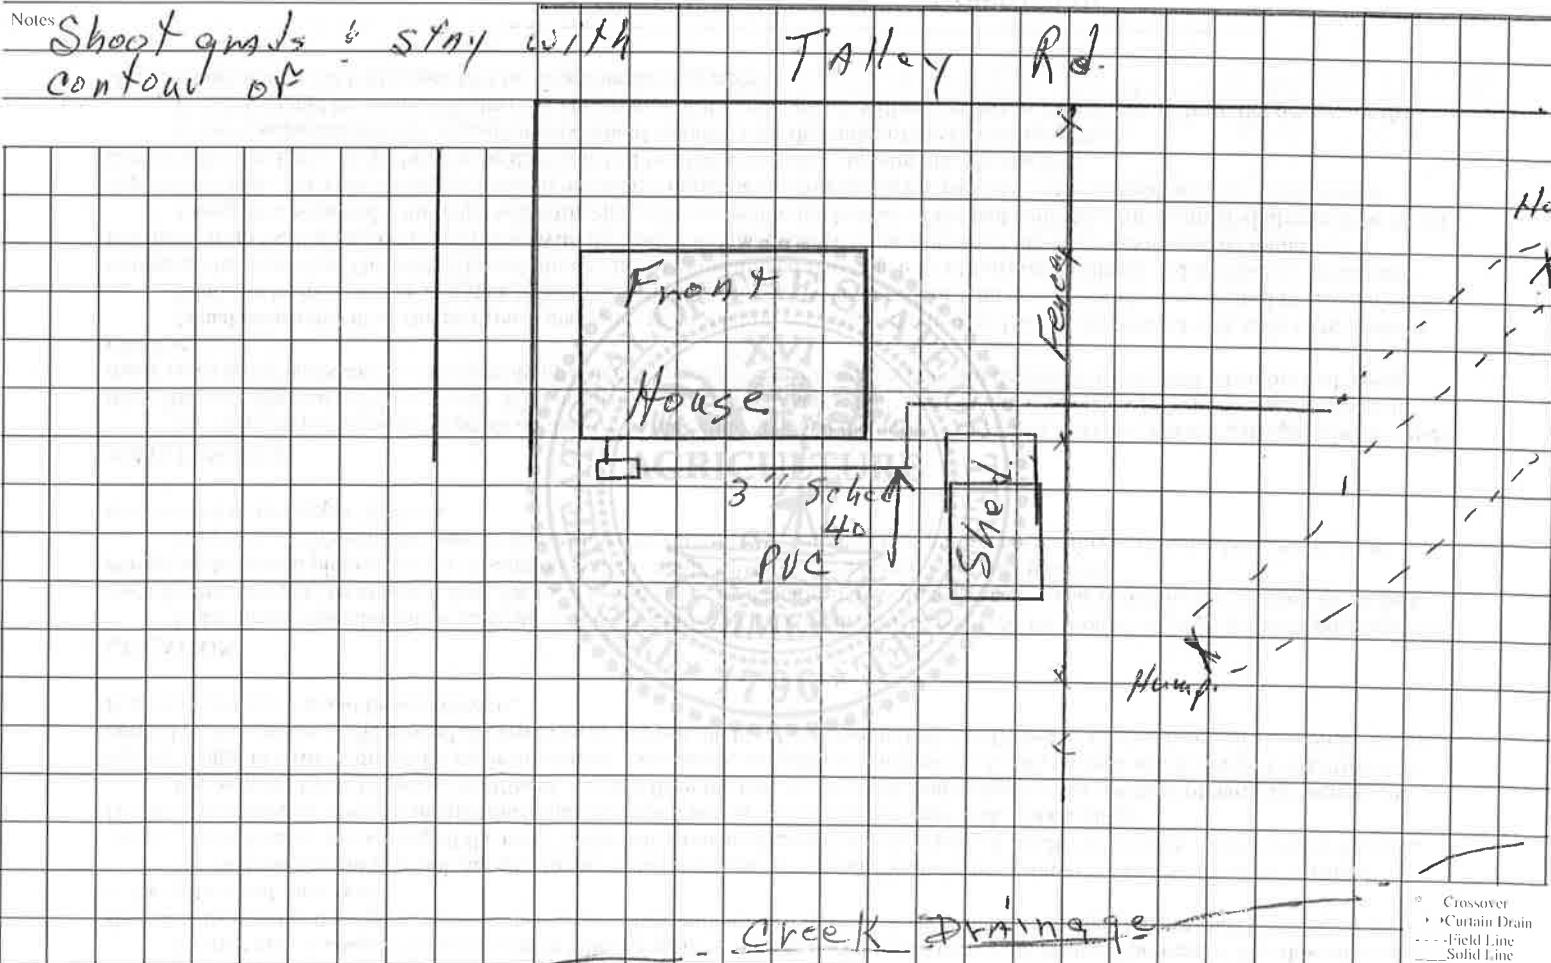

This is a permit to construct and is not intended to imply approval of any work proposed or completed on this lot.

**TENNESSEE DEPARTMENT OF HEALTH AND ENVIRONMENT**  
**CERTIFICATE OF COMPLETION OF SUBSURFACE SEWAGE DISPOSAL SYSTEM**

Issued to: Douglas Lowery Owner, Developer, Contractor, Installer, Etc.  
Location 2149 Tally Rd.

Type of System: ( ) 1. Standard ( ) 5. Mound  
( ) 2. Alternating ( ) 6. Lagoon  
( ) 3. Chapter \_\_\_\_\_ ( ) 7. Large Diameter Gravelless Pipe  
( ) 4. Low Pressure Pipe ( ) 8. Other 60-13-463 (i)

2 Comp-concrete 1000 Septic Tank  
(type) (volume)

Estimated Absorption Rate 48 (minutes per inch)

Digitized by srujanika@gmail.com

New Installation  Repair

Installed by: Travis Whaley

A hand-drawn sketch of a house plan on grid paper. The sketch shows a main rectangular house with a front entrance and a side entrance. A garage is attached to the side of the house. A driveway leads to the garage. The sketch includes various dimensions and angles: a 30° angle at the top right, a 32° angle on the left side, and a 50° angle at the top left. The sketch is labeled "House" and "Front". A vertical line on the right is labeled "Drive way". The sketch is drawn with black ink on white grid paper.

Talley Rd

#### Construction Approved By:

Don Odum Env. Spec.

4-31-92

(date)